

THIS DRAWING IS UNPUBLISHED.

RELEASED FOR PUBLICATION

20

© COPYRIGHT 20

BY -

ALL RIGHTS RESERVED.

REVISIONS

P	LTR	DESCRIPTION	DATE	DWN	APVD
	A	INITIAL RELEASE	23JUN2015	DL	CW
	A1	ECR-17-001721	13FEB2017	YC	CW
	A2	ECR-17-012365	26AUG2017	RL	CW

NOTES:
1. TECHNICAL CHARACTERISTICS:
HOUSING MATERIAL: DIE CAST ALUMINIUM ALLOY
SURFACE TREATMENT: POWDER COATED, GREY
DEGREE OF PROTECTION: IP65 (MATED)

注释:
1. 技术参数:
下壳材料: 铝合金
表面处理: 粉末喷涂, 灰色
防护等级: IP65 (配合)

HOUSING
下壳

TYPE 1: T1620163XXX-000 HI6B-SDRM-LB-PG/M
类型 1: T1620163XXX-000 HI6B下壳, 表面安装, 彩锌单扣, PG/M,
带金属保护盖, 灰色粉末喷涂

THIS DRAWING IS A CONTROLLED DOCUMENT.		DWN DAVID LI 23JUN2015	TE Connectivity NAME HI6B-SDRM-LB-PG/M SIZE A3 CAGE CODE - DRAWING NO C-T162016XXXXX00 RESTRICTED TO -		
DIMENSIONS: mm		CHK CHRIS WANG 23JUN2015			
		APVD XIANG XU 23JUN2015			
TOLERANCES UNLESS OTHERWISE SPECIFIED:		PRODUCT SPEC 108-137013			
MATERIAL		APPLICATION SPEC 114-137013	SCALE 1:2		
FINISH		WEIGHT -	SHEET 1 OF 3		
-		CUSTOMER DRAWING	REV A2		

THIS DRAWING IS UNPUBLISHED.

RELEASED FOR PUBLICATION

20



© COPYRIGHT 20

BY -


ALL RIGHTS RESERVED.

REVISIONS



P	LTR	DESCRIPTION	DATE	DWN	APVD
	-	SEE SHEET 1	-	-	-

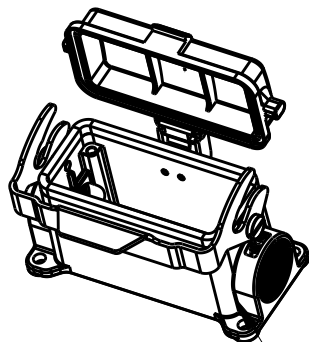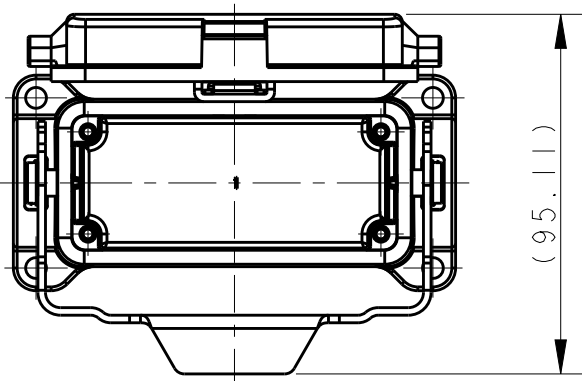

SCALE 3:10 HOUSING 下壳

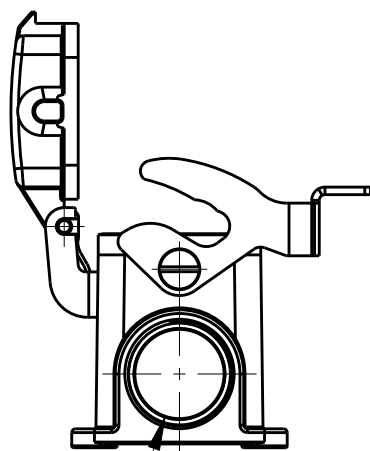


IG2

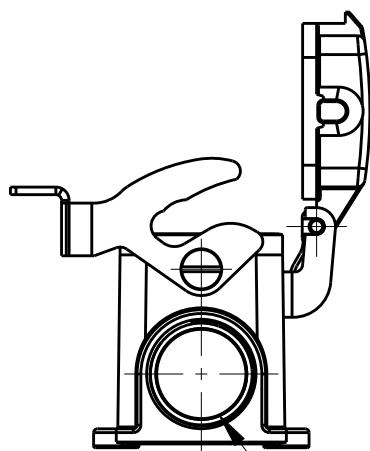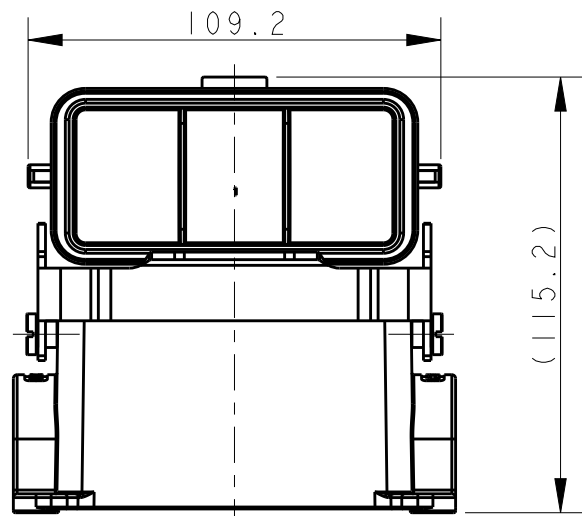


IG1

TYPE 2: TI620163XXX-000 HI6B-SDR-LB-PG/M
OTHER SPEC REFER TO TYPE 1

类型 2: TI620163XXX-000 HI6B下壳, 表面安装, 彩锌单扣, PG/M, 带塑料保护盖, 灰色粉末喷涂, 其余规范参照类型1

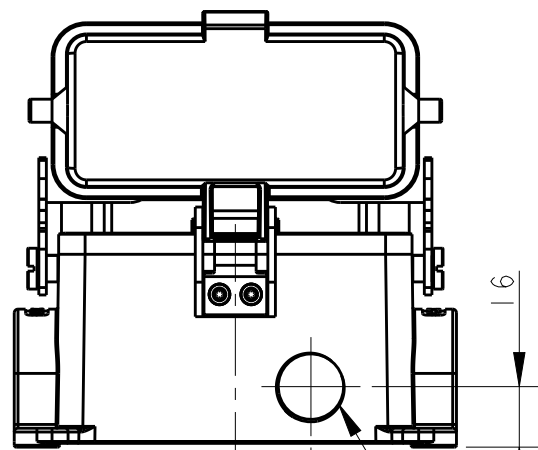

IG3


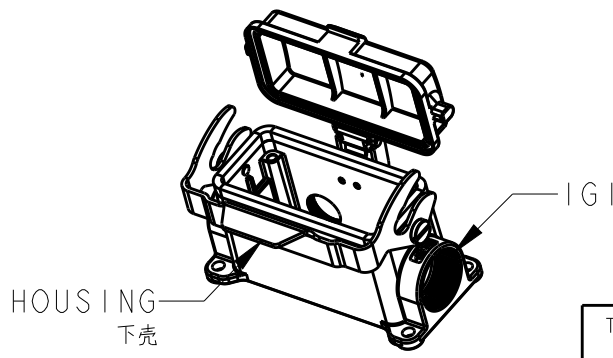


HOUSING 下壳

SCALE 3:10

TYPE 3: TI620162111-000 HI6B-SDR-LB-PG11/PG21
OTHER SPEC REFER TO TYPE 2

类型 3: TI620162111-000 HI6B下壳, 表面安装, 彩锌单扣, PG11 + 正面PG21, 带塑料保护盖, 灰色粉末喷涂, 其余规范参照类型2

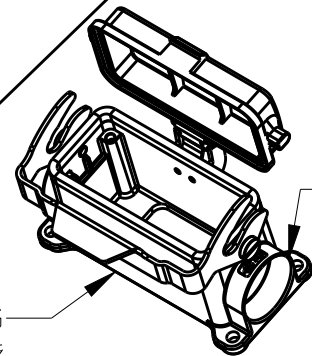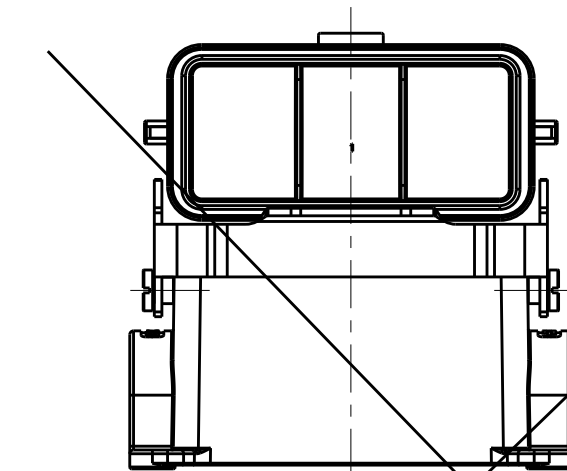

SCALE 3:10

HOUSING 下壳

IG1

TYPE 4: TI620163132-100 HI6B-SDR-LB-M32
OTHER SPEC REFER TO TYPE 2


类型 4: TI620163132-100 HI6B下壳, 表面安装, 彩锌单扣, M32, 带塑料保护盖, 底部铣槽, 灰色粉末喷涂, 其余规范参照类型2

OBSOLETE TYPE 4 PN
废除类型4料号

THIS DRAWING IS A CONTROLLED DOCUMENT.

DIMENSIONS:

mm

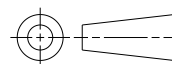

TOLERANCES UNLESS OTHERWISE SPECIFIED:

0 PLC	±0
1 PLC	±0.1
2 PLC	±0.2
3 PLC	±0.3
4 PLC	±0.4
ANGLES	±0.5

MATERIAL

-

FINISH

-

DWN 23JUN2015

DAVID LI

CHK 23JUN2015

CHRIS WANG

APVD 23JUN2015

XIANG XU

PRODUCT SPEC

108-137013

APPLICATION SPEC

114-137013

WEIGHT

-

CUSTOMER DRAWING



TE Connectivity

NAME

HI6B-SDRM-LB-PG/M

SIZE

A3

CAGE CODE

-

DRAWING NO

©-TI62016XXXXX00

RESTRICTED TO

-

SCALE

1:2

SHEET

2 OF 3

REV

A2

4

3

2

1

THIS DRAWING IS UNPUBLISHED.	RELEASED FOR PUBLICATION	20
© COPYRIGHT 20	BY -	ALL RIGHTS RESERVED.

REVISIONS					
P	LTR	DESCRIPTION	DATE	DWN	APVD
	-	SEE SHEET 1	-	-	-

NOTES:

SEE SHEET 1

注释:


参照 SHEET 1

T1620163421-000	H16B-SDRM-LB-PG21	H16B HOUSING,SURFACE MOUNTED,METAL SINGLE LOCKING,PG21,METAL PROTECTION COVER,POWDER COATED,GREY H16B下壳,表面安装,彩锌单扣,PG21,带金属保护盖,灰色粉末喷涂	PG21	-	-	TYPE 1 类型1	
T1620163425-000	H16B-SDRM-LB-M25	H16B HOUSING,SURFACE MOUNTED,METAL SINGLE LOCKING,M25,METAL PROTECTION COVER,POWDER COATED,GREY H16B下壳,表面安装,彩锌单扣,M25,带金属保护盖,灰色粉末喷涂	M25	-	-		
T1620163321-000	H16B-SDRM-LB-2PG21	H16B HOUSING,SURFACE MOUNTED,METAL SINGLE LOCKING,2PG21,METAL PROTECTION COVER,POWDER COATED,GREY H16B下壳,表面安装,彩锌单扣,2PG21,带金属保护盖,灰色粉末喷涂	PG21	PG21	-		
T1620163325-000	H16B-SDRM-LB-2M25	H16B HOUSING,SURFACE MOUNTED,METAL SINGLE LOCKING,2M25,METAL PROTECTION COVER,POWDER COATED,GREY H16B下壳,表面安装,彩锌单扣,2M25,带金属保护盖,灰色粉末喷涂	M25	M25	-		
T1620163121-000	H16B-SDR-LB-PG21	H16B HOUSING,SURFACE MOUNTED,METAL SINGLE LOCKING,PG21,PLASTIC PROTECTION COVER,POWDER COATED,GREY H16B下壳,表面安装,彩锌单扣,PG21,带塑料保护盖,灰色粉末喷涂	PG21	-	-	TYPE 2 类型2	
T1620163120-000	H16B-SDR-LB-M20	H16B HOUSING,SURFACE MOUNTED,METAL SINGLE LOCKING,M20,PLASTIC PROTECTION COVER,POWDER COATED,GREY H16B下壳,表面安装,彩锌单扣,M20,带塑料保护盖,灰色粉末喷涂	M20	-	-		
T1620163125-000	H16B-SDR-LB-M25	H16B HOUSING,SURFACE MOUNTED,METAL SINGLE LOCKING,M25,PLASTIC PROTECTION COVER,POWDER COATED,GREY H16B下壳,表面安装,彩锌单扣,M25,带塑料保护盖,灰色粉末喷涂	M25	-	-		
~~T1620163132-000~~	~~H16B-SDR-LB-M32~~	~~H16B HOUSING,SURFACE MOUNTED,METAL SINGLE LOCKING,M32,PLASTIC PROTECTION COVER,POWDER COATED,GREY H16B下壳,表面安装,彩锌单扣,M32,带塑料保护盖,灰色粉末喷涂~~	~~M32~~				
T1620163220-000	H16B-SDR-LB-2M20	H16B HOUSING,SURFACE MOUNTED,METAL SINGLE LOCKING,2M20,PLASTIC PROTECTION COVER,POWDER COATED,GREY H16B下壳,表面安装,彩锌单扣,2M20,带塑料保护盖,灰色粉末喷涂	M20	M20	-		
T1620163221-000	H16B-SDR-LB-2PG21	H16B HOUSING,SURFACE MOUNTED,METAL SINGLE LOCKING,2PG21,PLASTIC PROTECTION COVER,POWDER COATED,GREY H16B下壳,表面安装,彩锌单扣,2PG21,带塑料保护盖,灰色粉末喷涂	PG21	PG21	-		
T1620163225-000	H16B-SDR-LB-2M25	H16B HOUSING,SURFACE MOUNTED,METAL SINGLE LOCKING,2M25,PLASTIC PROTECTION COVER,POWDER COATED,GREY H16B下壳,表面安装,彩锌单扣,2M25,带塑料保护盖,灰色粉末喷涂	M25	M25	-		
T1620162111-000	H16B-SDR-LB-PG11/PG21	H16B HOUSING,SURFACE MOUNTED,METAL SINGLE LOCKING,PG11+FRONT ENTRY PG21,PLASTIC PROTECTION COVER,POWDER COATED,GREY H16B下壳,表面安装,彩锌单扣,PG11+正面PG21,带塑料保护盖,灰色粉末喷涂	PG21	-	PG11	TYPE 3 类型3	
~~T1620163132-100~~	~~H16B-SDR-LB-M32/T~~	~~H16B HOUSING,SURFACE MOUNTED,METAL SINGLE LOCKING,M32,PLASTIC PROTECTION COVER,MILL ON BOTTOM,POWDER COATED,GREY H16B下壳,表面安装,彩锌单扣,M32,带塑料保护盖,底部铣槽,灰色粉末喷涂~~	~~M32~~			TYPE 4 类型4	
PART NUMBER 料 号	PART DESCRIPTION 描 述			IG1	IG2	IG3	TYPE 类型

OBSOLETE
废除

OBSOLETE
废除

THIS DRAWING IS A CONTROLLED DOCUMENT.		DWN DAVID LI 23JUN2015	 TE Connectivity			
		CHK CHRIS WANG 23JUN2015				
		APVD XIANG XU 23JUN2015				
		PRODUCT SPEC 108-137013				
		APPLICATION SPEC 114-137013	NAME H16B-SDRM-LB-PG/M			
		WEIGHT -	SIZE A3	CAGE CODE -	DRAWING NO T162016XXXXX00	RESTRICTED TO -
CUSTOMER DRAWING		SCALE 1:2	SHEET 3	OF 3	REV A2	

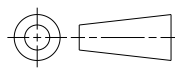DIMENSIONS: mm	TOLERANCES UNLESS OTHERWISE SPECIFIED:
	0 PLC ± 1 PLC ± 2 PLC ± 3 PLC ± 4 PLC ± ANGLES ±
MATERIAL -	FINISH -
-	-

Данный компонент на территории Российской Федерации

Вы можете приобрести в компании MosChip.

Для оперативного оформления запроса Вам необходимо перейти по данной ссылке:

<http://moschip.ru/get-element>

Вы можете разместить у нас заказ для любого Вашего проекта, будь то серийное производство или разработка единичного прибора.

В нашем ассортименте представлены ведущие мировые производители активных и пассивных электронных компонентов.

Нашей специализацией является поставка электронной компонентной базы двойного назначения, продукции таких производителей как XILINX, Intel (ex.ALTERA), Vicor, Microchip, Texas Instruments, Analog Devices, Mini-Circuits, Amphenol, Glenair.

Сотрудничество с глобальными дистрибьюторами электронных компонентов, предоставляет возможность заказывать и получать с международных складов практически любой перечень компонентов в оптимальные для Вас сроки.

На всех этапах разработки и производства наши партнеры могут получить квалифицированную поддержку опытных инженеров.

Система менеджмента качества компании отвечает требованиям в соответствии с ГОСТ Р ИСО 9001, ГОСТ РВ 0015-002 и ЭС РД 009

Офис по работе с юридическими лицами:

105318, г.Москва, ул.Щербаковская д.3, офис 1107, 1118, ДЦ «Щербаковский»

Телефон: +7 495 668-12-70 (многоканальный)

Факс: +7 495 668-12-70 (доб.304)

E-mail: info@moschip.ru

Skype отдела продаж:

moschip.ru

moschip.ru_4

moschip.ru_6

moschip.ru_9