REV		DESCRIPTION	DATE	APPROVED
A		ADDED ITEM #3 45666-010 PRIMARY ASSEMBLY	01/12/14	CC
B	06-006920	ADDED ITEM 5, ESD SYMBOL & REMOVED NOT RELEASED NOTE	06/03/10	CB
C	06-006920	MARKUP WAS INCORRECT IN DM TEC	06/03/10	CB
D	07-006969	ADDED BOTTOM VIEW	07/03/12	CB

ENGR 14-013073
DATE 9-2-14
APPROVED
PREPARED DSH

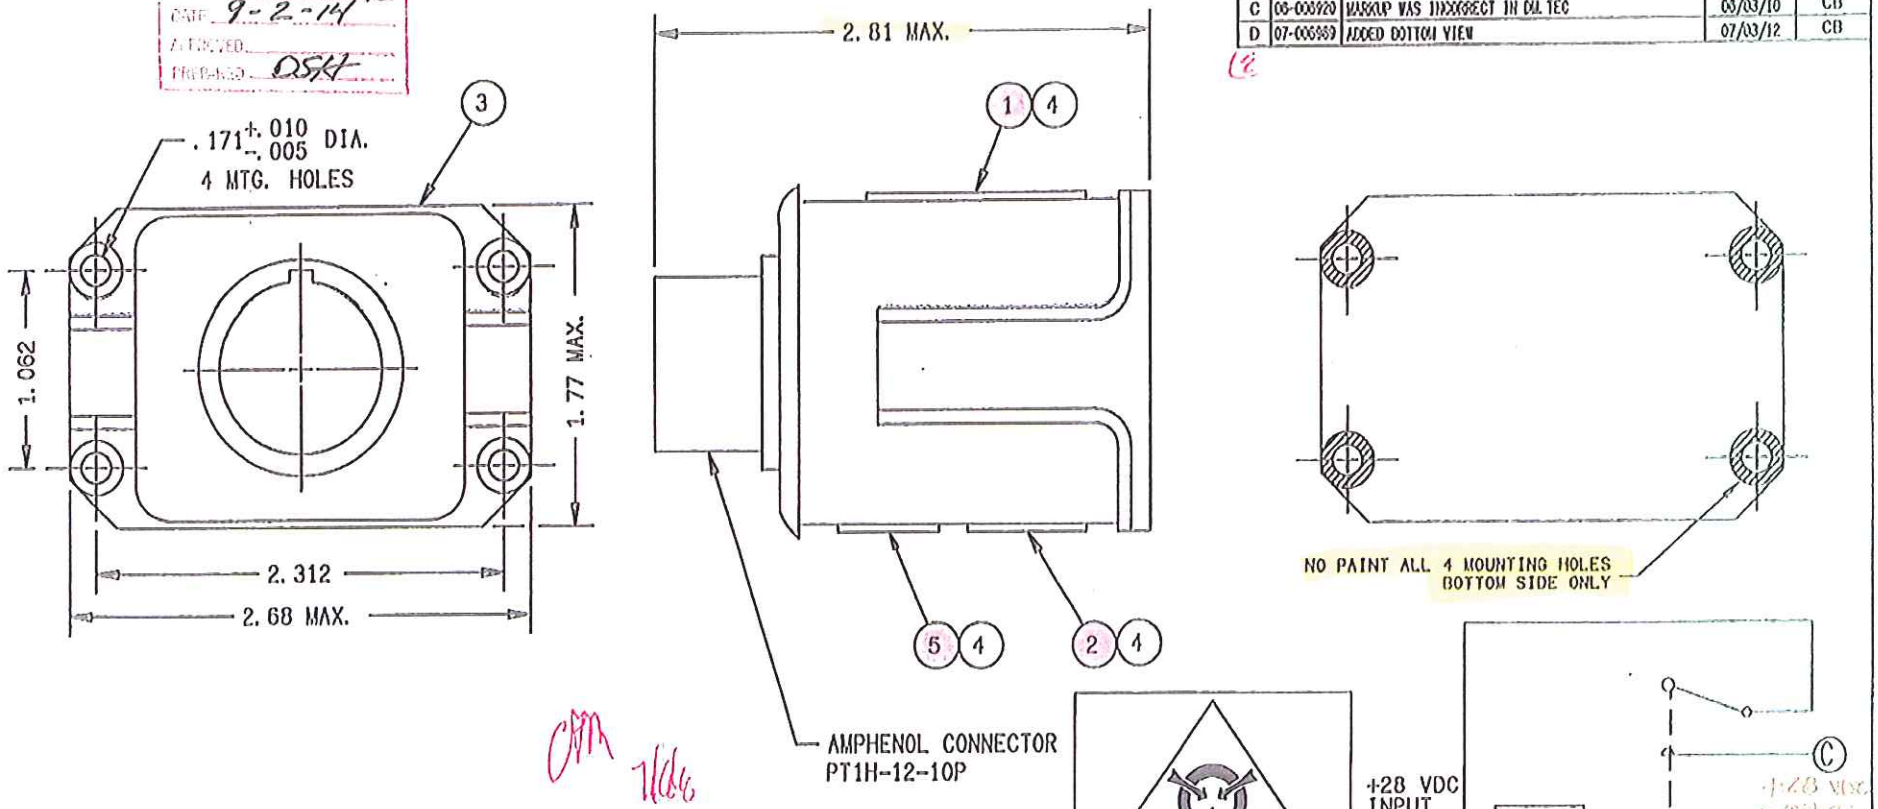

CAM 7/16/10

RSS 7/16/10

DD 7/16/10

CONSTRUCTION	METAL CASE, POTTED ASSEMBLY WITH CONTACTS HERMETICALLY SEALED
MIN. OPER. CYCLES	50,000
ENVIRONMENTAL DATA	
OPER. TEMP.	-55°C TO +71°C
CONTACT DATA	
CONTACTS	SPST N.O.
CONTACT RATING	
RESISTIVE	5 AMP
INDUCTIVE	1 AMP
WEIGHT MAX.	8 OZ.

OPERATING CHARACTERISICS:
CONTACTS CLOSE AT 24.5 ±0.5 VDC WITH A 1 ±0.15 SEC. TIME DELAY. CONTACTS OPEN AT 30 ±0.5 VDC WITH A 0.30 TO 0.60 SECOND TIME DELAY AND AT 34 ±0.5 VDC WITH A 40 TO 60 MILLISECOND TIME DELAY. CONTACTS RECLOSE WHEN THE VOLTAGE DECREASES TO 28.5 ±0.5 VDC FROM AN OVERVOLTAGE CONDITION. CONTACTS OPEN AT 16 ±0.5 VDC WITH A TIME DELAY OF 0.50 ±0.10 SECONDS

NOTE
CONTACTS WILL NOT CLOSE ON REVERSED INPUT VOLTAGE POLARITY.

FIND NO	QTY REQD	PART OR IDENTIFYING NO	NOMENCLATURE OR DESCRIPTION	FSCM NO	DRAWING OR SPECIFICATION	MATERIAL OR NOTE
5	1	41211-001	PLATE ESD			
4	3	39529-001	OVERLAY			
3	1	45666-010	RELAY ASSEMBLY PRI.			
2	1	40453-001	PLATE - WIRING DIAGRAM			
1	1	16043-001	PLATE - NAME			

UNLESS OTHERWISE SPECIFIED DIMENSIONS ARE IN INCHES TOLERANCES ON

2 PL. DEC.	3 PL. DEC.	ANGLES
± .02	± .010	± 1

DR BY	EAD	01/12/14
CHK BY	CC	03/02/13
ENGR	RSS	03/02/13
MFG	MH	03/02/13
SIZE C	CODE IDENT 74063	
SCALE NONE	SHEET	

Tyco Electronics
Hartman Division, 175 N. DIAMOND STREET MANSFIELD, OHIO 44902

MONITOR, EXTERNAL POWER
093

DWG NO. E-311AAJ

REF TYCO P/N 2-1616542-8

Общество с ограниченной ответственностью «МосЧип» ИНН 7719860671 / КПП 771901001
Адрес: 105318, г.Москва, ул.Щербаковская д.3, офис 1107

Данный компонент на территории Российской Федерации

Вы можете приобрести в компании MosChip.

Для оперативного оформления запроса Вам необходимо перейти по данной ссылке:

http://moschip.ru/get-element

Вы можете разместить у нас заказ для любого Вашего проекта, будь то серийное производство или разработка единичного прибора.

В нашем ассортименте представлены ведущие мировые производители активных и пассивных электронных компонентов.

Нашей специализацией является поставка электронной компонентной базы двойного назначения, продукции таких производителей как XILINX, Intel (ex.ALTERA), Vicor, Microchip, Texas Instruments, Analog Devices, Mini-Circuits, Amphenol, Glenair.

Сотрудничество с глобальными дистрибьюторами электронных компонентов, предоставляет возможность заказывать и получать с международных складов практически любой перечень компонентов в оптимальные для Вас сроки.

На всех этапах разработки и производства наши партнеры могут получить квалифицированную поддержку опытных инженеров.

Система менеджмента качества компании отвечает требованиям в соответствии с ГОСТ Р ИСО 9001, ГОСТ РВ 0015-002 и ЭС РД 009

Офис по работе с юридическими лицами:

105318, г.Москва, ул.Щербаковская д.3, офис 1107, 1118, ДЦ «Щербаковский»

Телефон: +7 495 668-12-70 (многоканальный)

Факс: +7 495 668-12-70 (доб.304)

E-mail: info@moschip.ru

Skype отдела продаж:
moschip.ru
moschip.ru_4
moschip.ru_6
moschip.ru_9