

THIS DRAWING IS UNPUBLISHED. RELEASED FOR PUBLICATION MAR ,2006.
© COPYRIGHT 2009 By – ALL RIGHTS RESERVED.


LOC	DIST
IR	—


REVISIONS

P	LTR	DESCRIPTION	DATE	DWN	APVD
	B	RELEASED AS PER ECR-09-017658	06AUG09	SRE	PCH
	B1	ECR-10-026537	21JAN11	KK	HMR

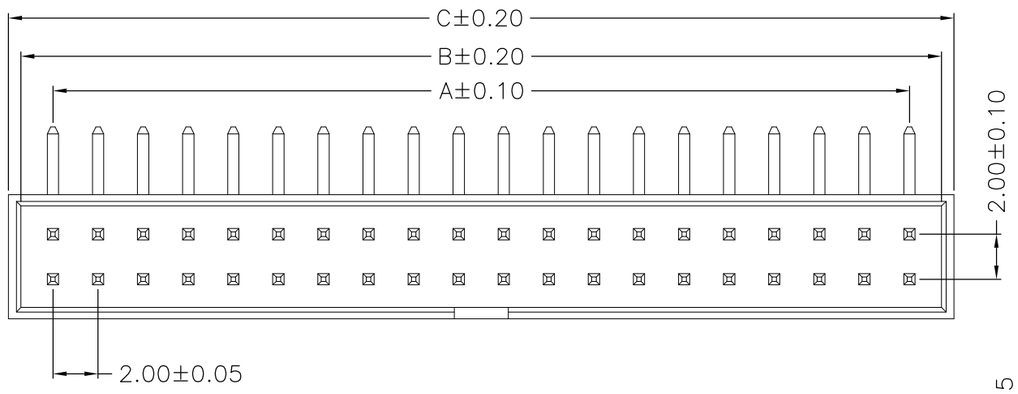

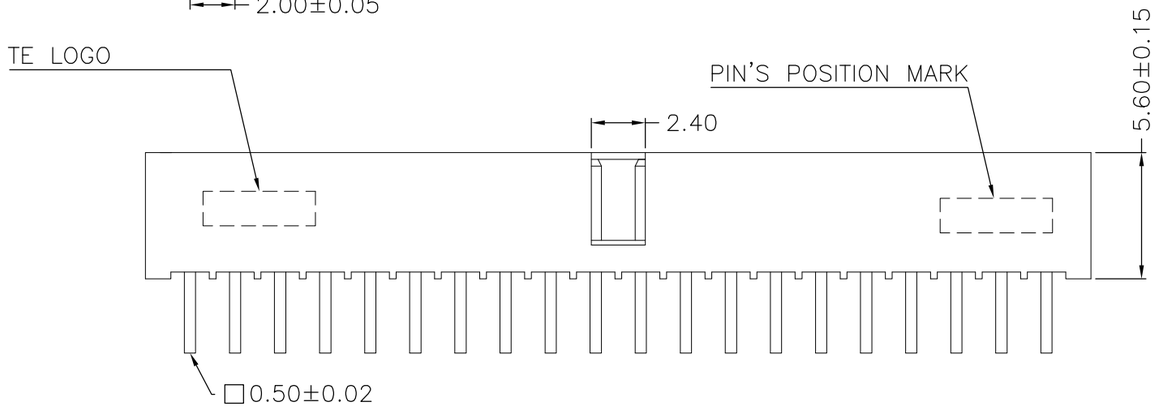

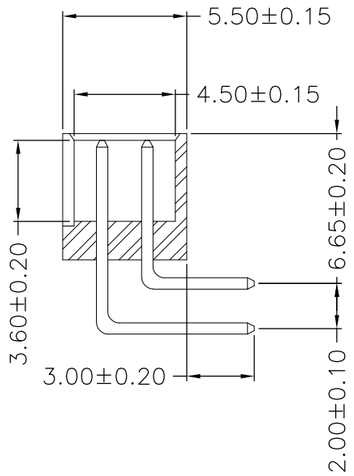

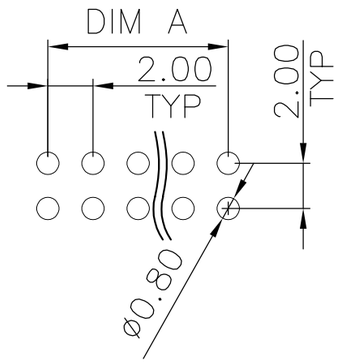

RECOMMENDED PCB LAYOUT (THICKNESS: 1.6mm)

(TOP VIEW) (TOLERANCE: ±0.05)

NOTE:

1. MATERIAL :
   HOUSING : NYLON 6T, UL94V-0, BLACK COLOUR.
   CONTACT : BRASS, THICKNESS=0.5mm
2. FINISH:
   CONTACT: 10μ" MIN. GOLD PLATED ON CONTACT AREA,
   100μ" MIN. MATTE TIN PLATED ON SOLDERTAILS,
   50μ" MIN. NICKEL UNDERPLATED OVERALL
3. WAVE SOLDER CAPABLE TO 265°C PER TE SPEC 109-202, CONDITION B
4. QUALIFICATION TEST REPORT: 501-57197

	POS.	A	B	C	PART NUMBER
		DIMENSIONS			
OBSOLETE	~~64~~	~~62.00~~	~~64.85~~	~~65.95~~	~~6-1734493-4~~
	~~62~~	~~60.00~~	~~62.85~~	~~63.95~~	~~6-1734493-2~~
	~~60~~	~~58.00~~	~~60.85~~	~~61.95~~	~~6-1734493-0~~
	~~58~~	~~56.00~~	~~58.85~~	~~59.95~~	~~5-1734493-8~~
	~~56~~	~~54.00~~	~~56.85~~	~~57.95~~	~~5-1734493-6~~
	~~54~~	~~52.00~~	~~54.85~~	~~55.95~~	~~5-1734493-4~~
OBSOLETE	~~52~~	~~50.00~~	~~52.85~~	~~53.95~~	~~5-1734493-2~~
	50	48.00	50.85	51.95	5-1734493-0
	48	46.00	48.85	49.95	4-1734493-8
	46	44.00	46.85	47.95	4-1734493-6
OBSOLETE	44	42.00	44.85	45.95	~~4-1734493-4~~
	42	40.00	42.85	43.95	4-1734493-2
	40	38.00	40.85	41.95	4-1734493-0
	38	36.00	38.85	39.95	3-1734493-8
	36	34.00	36.85	37.95	3-1734493-6
OBSOLETE	34	32.00	34.85	35.95	~~3-1734493-4~~
	32	30.00	32.85	33.95	3-1734493-2
	30	28.00	30.85	31.95	3-1734493-0
	28	26.00	28.85	29.95	2-1734493-8
OBSOLETE	26	24.00	26.85	27.95	~~2-1734493-6~~
	24	22.00	24.85	25.95	2-1734493-4
	22	20.00	22.85	23.95	2-1734493-2
	20	18.00	20.85	21.95	2-1734493-0
OBSOLETE	18	16.00	18.85	19.95	~~1-1734493-8~~
	16	14.00	16.85	17.95	1-1734493-6
	14	12.00	14.85	15.95	1-1734493-4
	12	10.00	12.85	13.95	1-1734493-2
OBSOLETE	10	8.00	10.85	11.95	~~1-1734493-0~~
	8	6.00	8.85	9.95	0-1734493-8
	6	4.00	6.85	7.95	0-1734493-6
	4	2.00	4.85	5.95	0-1734493-4

THIS DRAWING IS A CONTROLLED DOCUMENT.

DIMENSIONS: mm

TOLERANCES UNLESS OTHERWISE SPECIFIED:
0 PLC ± –
1 PLC ± 0.20
2 PLC ± 0.15
3 PLC ± 0.10
4 PLC ± –
ANGLES ± –

MATERIAL 1

FINISH 2

DWN O.HU 28-MAR-2006
CHK S.HOU 28-MAR-2006
APVD W.J.KE 28-MAR-2006
PRODUCT SPEC 108-57197
APPLICATION SPEC —
WEIGHT —

TE Connectivity

NAME
AMPMODU 2.0mm PITCH,
RIGHT ANGLE,DUAL ROW,
THRU-HOLE

SIZE	CAGE CODE	DRAWING NO	RESTRICTED TO
A3	–	C-1734493	—

CUSTOMER DRAWING


SCALE	SHEET	REV
1:1	1 OF 2	B1

THIS DRAWING IS UNPUBLISHED. RELEASED FOR PUBLICATION MAR ,2006.
© COPYRIGHT 2009 By – ALL RIGHTS RESERVED.


LOC	DIST
IR	—


REVISIONS


P	LTR	DESCRIPTION	DATE	DWN	APVD
	–	SEE SHEET 1			

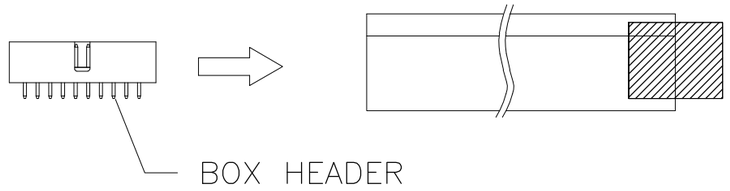



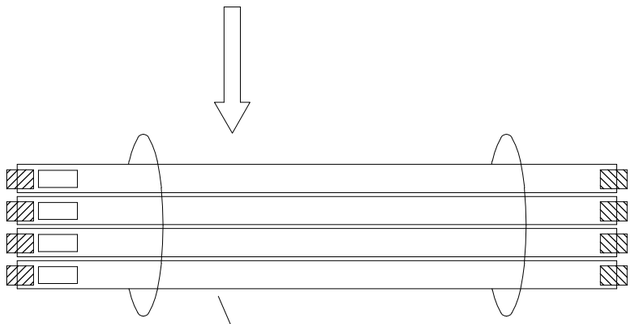

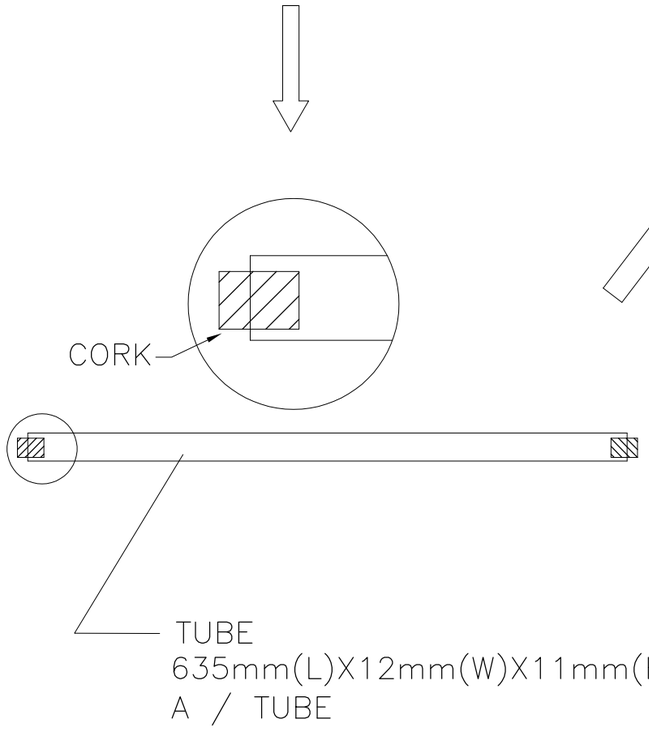

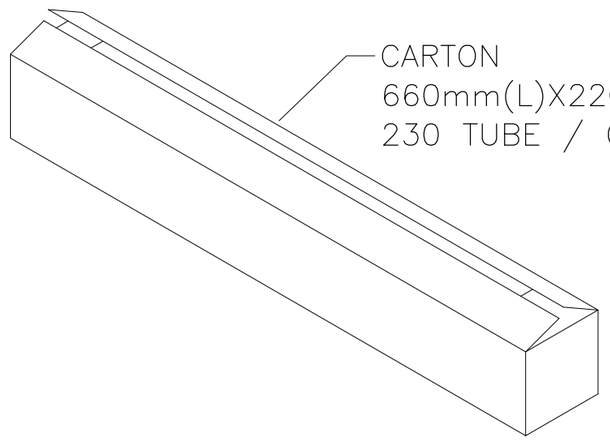

	PCS/ CARTON	PCS/ TUBE	POS.	PART NUMBER
OBSOLETE	~~2,070~~	~~9~~	~~64~~	~~6–1734493–4~~
	~~2.070~~	~~9~~	~~62~~	~~6–1734493–2~~
	~~2,070~~	~~9~~	~~60~~	~~6–1734493–0~~
	~~2,300~~	~~10~~	~~58~~	~~5–1734493–8~~
	~~2,300~~	~~10~~	~~56~~	~~5–1734493–6~~
	~~2,300~~	~~10~~	~~54~~	~~5–1734493–4~~
OBSOLETE	~~2,530~~	~~11~~	~~52~~	~~5–1734493–2~~
	2,530	11	50	5–1734493–0
	2,760	12	48	4–1734493–8
	2,760	12	46	4–1734493–6
OBSOLETE	2,990	13	44	~~4–1734493–4~~
	2,990	13	42	4–1734493–2
	3,220	14	40	4–1734493–0
	3,450	15	38	3–1734493–8
	3,450	15	36	3–1734493–6
OBSOLETE	3,680	16	34	~~3–1734493–4~~
	3,910	17	32	3–1734493–2
	4,140	18	30	3–1734493–0
	4,600	20	28	2–1734493–8
OBSOLETE	4,830	21	26	~~2–1734493–6~~
	5,290	23	24	2–1734493–4
	5,750	25	22	2–1734493–2
	6,210	27	20	2–1734493–0
OBSOLETE	6,900	30	18	~~1–1734493–8~~
	7,590	33	16	1–1734493–6
	8,510	37	14	1–1734493–4
	9,660	42	12	1–1734493–2
OBSOLETE	11,500	50	10	~~1–1734493–0~~
	13,800	60	8	0–1734493–8
	17,250	75	6	0–1734493–6
	23,000	100	4	0–1734493–4

THIS DRAWING IS A CONTROLLED DOCUMENT.

DIMENSIONS: mm

TOLERANCES UNLESS OTHERWISE SPECIFIED:
0 PLC ± –
1 PLC ± 0.20
2 PLC ± 0.15
3 PLC ± 0.10
4 PLC ± –
ANGLES ± –

MATERIAL: SEE SHEET 1

FINISH: SEE SHEET 1

DWN O.HU 28–MAR–2006
CHK S.HOU 28–MAR–2006
APVD W.J.KE 28–MAR–2006
PRODUCT SPEC 108–57197
APPLICATION SPEC —
WEIGHT —

CUSTOMER DRAWING

TE Connectivity

NAME: AMPMODU 2.0mm PITCH, RIGHT ANGLE,DUAL ROW, THRU–HOLE

SIZE	CAGE CODE	DRAWING NO	RESTRICTED TO
A3	–	C–1734493	—

SCALE	SHEET	REV
1:1	2 OF 2	B1

Общество с ограниченной ответственностью «МосЧип» ИНН 7719860671 / КПП 771901001
Адрес: 105318, г.Москва, ул.Щербаковская д.3, офис 1107

Данный компонент на территории Российской Федерации

Вы можете приобрести в компании MosChip.

Для оперативного оформления запроса Вам необходимо перейти по данной ссылке:

http://moschip.ru/get-element

Вы можете разместить у нас заказ для любого Вашего проекта, будь то серийное производство или разработка единичного прибора.

В нашем ассортименте представлены ведущие мировые производители активных и пассивных электронных компонентов.

Нашей специализацией является поставка электронной компонентной базы двойного назначения, продукции таких производителей как XILINX, Intel (ex.ALTERA), Vicor, Microchip, Texas Instruments, Analog Devices, Mini-Circuits, Amphenol, Glenair.

Сотрудничество с глобальными дистрибьюторами электронных компонентов, предоставляет возможность заказывать и получать с международных складов практически любой перечень компонентов в оптимальные для Вас сроки.

На всех этапах разработки и производства наши партнеры могут получить квалифицированную поддержку опытных инженеров.

Система менеджмента качества компании отвечает требованиям в соответствии с ГОСТ Р ИСО 9001, ГОСТ РВ 0015-002 и ЭС РД 009

Офис по работе с юридическими лицами:

105318, г.Москва, ул.Щербаковская д.3, офис 1107, 1118, ДЦ «Щербаковский»

Телефон: +7 495 668-12-70 (многоканальный)

Факс: +7 495 668-12-70 (доб.304)

E-mail: info@moschip.ru

Skype отдела продаж:
moschip.ru
moschip.ru_4
moschip.ru_6
moschip.ru_9