THIS DRAWING IS UNPUBLISHED. RELEASED FOR PUBLICATION –,– .
© COPYRIGHT – By – ALL RIGHTS RESERVED.

REVISIONS

P	LTR	DESCRIPTION	DATE	DWN	APVD
	3	STRIKE THROUGH OBS PARTS. ECR-16-009583	08JUL2016	AFK	LS
	2	ECR-13-007797	07MAY2013	KR	KA

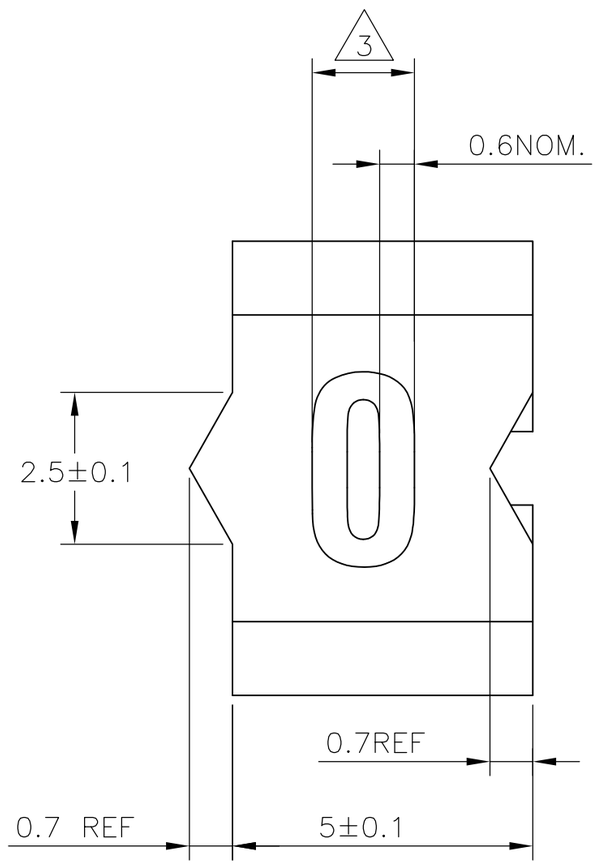

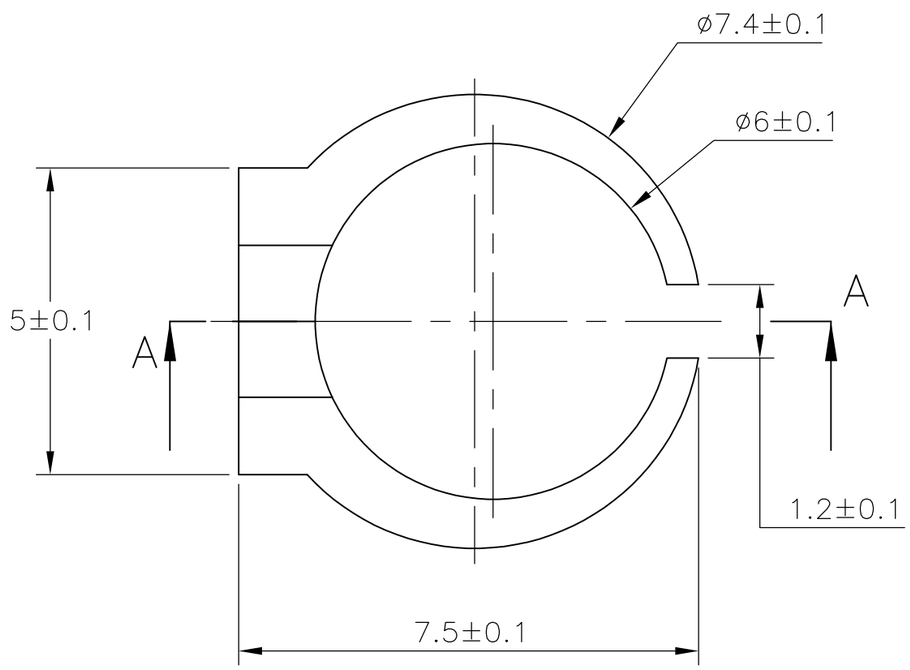

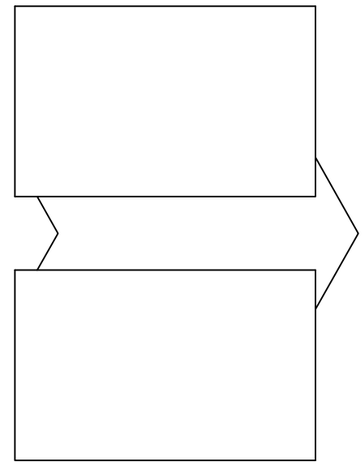

A–A

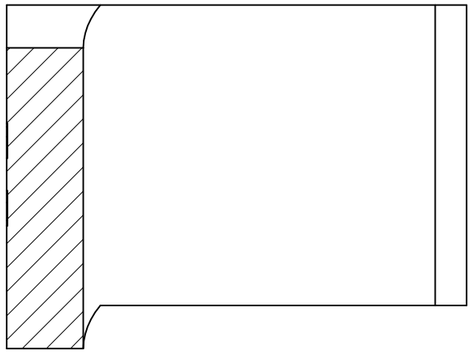

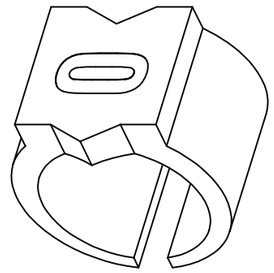

NOTES:

1. FOR PART NUMBER SEE SHEET 3 OF 3.
2. MARK SHOULD BE CENTRALLY POSITIONED ±0.1mm.
3. WIDTH OF MARK DEPENDS ON CHARACTER PRINTED

THIS DRAWING IS A CONTROLLED DOCUMENT.

DIMENSIONS: mm

TOLERANCES UNLESS OTHERWISE SPECIFIED:
0 PLC ± –
1 PLC ± –
2 PLC ± –
3 PLC ± –
4 PLC ± –
ANGLES ± –

MATERIAL –

FINISH –

DWN RAGHAVENDRA K 22MAR2013
CHK KEAN ALAN 22MAR2013
APVD MARIO APPELLO 22MAR2013
PRODUCT SPEC –
APPLICATION SPEC –
WEIGHT 0

CUSTOMER DRAWING

TE Connectivity

NAME SNAP-ON MARKER STB/STD SIZE 15 WITH APPLICATOR
–
–

SIZE	CAGE CODE	DRAWING NO	RESTRICTED TO
A3	00779	C-7-1768045-4	–

SCALE NTS SHEET 1 OF 3 REV 3

THIS DRAWING IS UNPUBLISHED. RELEASED FOR PUBLICATION – ,– .
© COPYRIGHT – By – ALL RIGHTS RESERVED.

REVISIONS

P	LTR	DESCRIPTION	DATE	DWN	APVD
	–	SEE SHEET 1	–	—	—

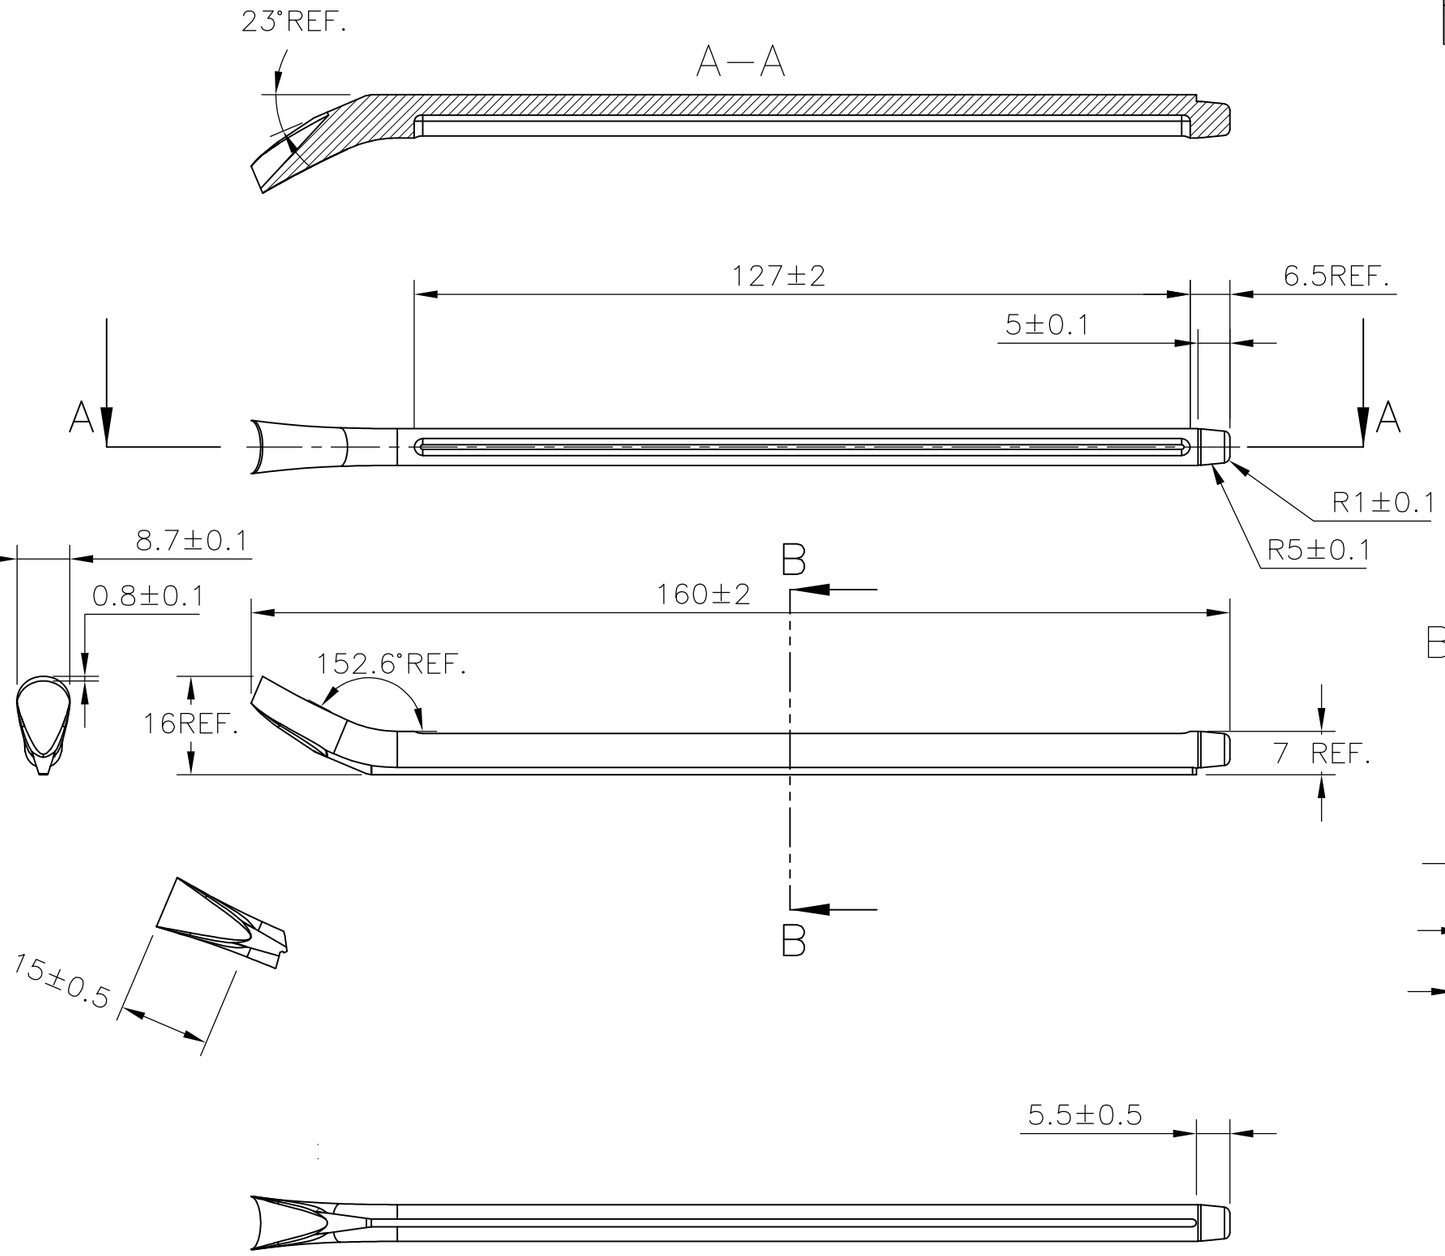

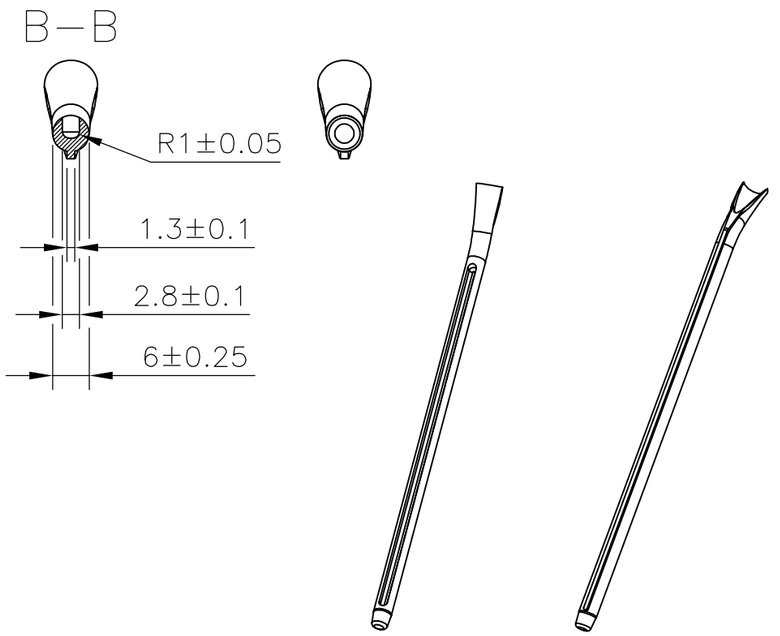

THIS DRAWING IS A CONTROLLED DOCUMENT.

DIMENSIONS: mm

TOLERANCES UNLESS OTHERWISE SPECIFIED:
0 PLC ± –
1 PLC ± –
2 PLC ± –
3 PLC ± –
4 PLC ± –
ANGLES ± –

MATERIAL –

FINISH –

DWN RAGHAVENDRA K 22MAR2013
CHK KEAN ALAN 22MAR2013
APVD MARIO APPELLO 22MAR2013
PRODUCT SPEC —
APPLICATION SPEC —
WEIGHT —

TE Connectivity

NAME SNAP–ON MARKER STB/STD SIZE 15 WITH APPLICATOR
–

SIZE	CAGE CODE	DRAWING NO	RESTRICTED TO
A3	00779	C–7–1768045–4	—

CUSTOMER DRAWING | SCALE NTS | SHEET 2 OF 3 | REV 3

THIS DRAWING IS UNPUBLISHED. RELEASED FOR PUBLICATION –,– .
© COPYRIGHT – By – ALL RIGHTS RESERVED.

REVISIONS

P	LTR	DESCRIPTION	DATE	DWN	APVD
	–	SEE SHEET 1	–	—	—

DESCRIPTION	PART NO.
STB15–0–0	6–1768039–0
STB15–1–1	6–1768039–1
STB15–1–2	2–1768413–1
STB15–1–3	9–1768412–3
STB15–1–5	6–1768039–2
STB15–2–2	6–1768039–4
STB15–2–5	6–1768039–5
STB15–3–2	2–1768413–2
STB15–3–3	6–1768039–7
STB15–4–2	2–1768413–3
STB15–5–2	2–1768413–4
STB15–5–5	7–1768039–0
STB15–6–6	7–1768039–2
STB15–7–7	7–1768039–3
STB15–8–8	7–1768039–6
STB15–A–3	7–1768039–7
STB15–A–5	7–1768039–8
STB15–BLANK–0	8–1768039–0
STB15–BLANK–1	8–1768039–1
STB15–BLANK–2	8–1768039–2
STB15–BLANK–3	8–1768039–3
STB15–BLANK–5	8–1768039–4
STB15–BLANK–6	8–1768039–5
STB15–BLANK–7	8–1768039–6
STB15–BLANK–8	8–1768039–7
STB15–F–6	8–1768039–9
STB15–H–2	9–1768039–0
STB15–H–5	7–1768418–2
STB15–L–5	9–1768039–2
STB15–R–0	9–1768039–6
STB15–R–5	9–1768039–8
STB15–S–5	7–1768418–3

DESCRIPTION	PART NO.
STB15–T–6	1768040–1
STB15–V–6	1768040–3
STD15–APPLICATOR	5–1768045–4
STD15W–0	5–1768045–5

STD15Y–0	7–1768045–4
STD15Y–1	7–1768045–5
STD15Y–2	7–1768045–6
STD15Y–3	7–1768045–7
STD15Y–4	7–1768045–8
STD15Y–5	7–1768045–9
STD15Y–6	8–1768045–0
STD15Y–7	8–1768045–1
STD15Y–8	8–1768045–2
STD15Y–9	8–1768045–3
STD15Y–A	8–1768045–4
STD15Y–B	8–1768045–7
STD15Y–BLANK	8–1768045–8
STD15Y–C	9–1768045–0

DESCRIPTION	PART NO.
STD15Y–COLON	9–1768045–1
STD15Y–D	9–1768045–2
STD15Y–DOT	9–1768045–4
STD15Y–E	9–1768045–5
STD15Y–EARTH	9–1768045–6
STD15Y–F	9–1768045–8
STD15Y–G	1768046–1
STD15Y–H	1768046–3
STD15Y–I	1768046–5
STD15Y–J	1768046–6
STD15Y–K	1768046–7
STD15Y–L	1768046–9
STD15Y–M	1–1768046–1
STD15Y–MINUS	1–1768046–2
STD15Y–N	1–1768046–4
STD15Y–P	1–1768046–6
STD15Y–PLUS	1–1768046–7
STD15Y–Q	1–1768046–8
STD15Y–R	1–1768046–9
STD15Y–S	2–1768046–1
STD15Y–SLASH	2–1768046–2
STD15Y–T	2–1768046–3
STD15Y–U	2–1768046–4
STD15Y–V	2–1768046–5
STD15Y–W	2–1768046–6
STD15Y–X	2–1768046–7
STD15Y–Y	2–1768046–8
STD15Y–Z	2–1768046–9

4 OBSOLETE PART

THIS DRAWING IS A CONTROLLED DOCUMENT.

DIMENSIONS: mm

TOLERANCES UNLESS OTHERWISE SPECIFIED:
0 PLC ± –
1 PLC ± –
2 PLC ± –
3 PLC ± –
4 PLC ± –
ANGLES ± –

MATERIAL –

FINISH –

DWN RAGHAVENDRA K 22MAR2013
CHK KEAN ALAN 22MAR2013
APVD MARIO APPELLO 22MAR2013
PRODUCT SPEC —
APPLICATION SPEC —
WEIGHT —

TE Connectivity

NAME SNAP–ON MARKER STB/STD SIZE 15 WITH APPLICATOR
–

SIZE	CAGE CODE	DRAWING NO	RESTRICTED TO
A3	00779	C–7–1768045–4	—

CUSTOMER DRAWING | SCALE NTS | SHEET 3 OF 3 | REV 3

Общество с ограниченной ответственностью «МосЧип» ИНН 7719860671 / КПП 771901001
Адрес: 105318, г.Москва, ул.Щербаковская д.3, офис 1107

Данный компонент на территории Российской Федерации

Вы можете приобрести в компании MosChip.

Для оперативного оформления запроса Вам необходимо перейти по данной ссылке:

http://moschip.ru/get-element

Вы можете разместить у нас заказ для любого Вашего проекта, будь то серийное производство или разработка единичного прибора.

В нашем ассортименте представлены ведущие мировые производители активных и пассивных электронных компонентов.

Нашей специализацией является поставка электронной компонентной базы двойного назначения, продукции таких производителей как XILINX, Intel (ex.ALTERA), Vicor, Microchip, Texas Instruments, Analog Devices, Mini-Circuits, Amphenol, Glenair.

Сотрудничество с глобальными дистрибьюторами электронных компонентов, предоставляет возможность заказывать и получать с международных складов практически любой перечень компонентов в оптимальные для Вас сроки.

На всех этапах разработки и производства наши партнеры могут получить квалифицированную поддержку опытных инженеров.

Система менеджмента качества компании отвечает требованиям в соответствии с ГОСТ Р ИСО 9001, ГОСТ РВ 0015-002 и ЭС РД 009

Офис по работе с юридическими лицами:

105318, г.Москва, ул.Щербаковская д.3, офис 1107, 1118, ДЦ «Щербаковский»

Телефон: +7 495 668-12-70 (многоканальный)

Факс: +7 495 668-12-70 (доб.304)

E-mail: info@moschip.ru

Skype отдела продаж:
moschip.ru
moschip.ru_4
moschip.ru_6
moschip.ru_9